


FÖRKLARINGAR

- DM DISKMASKIN
G GARDEROB
ST STÅD
K KYL
F FRY
K/F KYL/FRYS
TT TORKTUMLARE
TM TVÄTTMASKIN
TP TVÄTTPELARE
B BACKSKÅP
▲ ENTRÉPIL
ELC ELCENTRAL

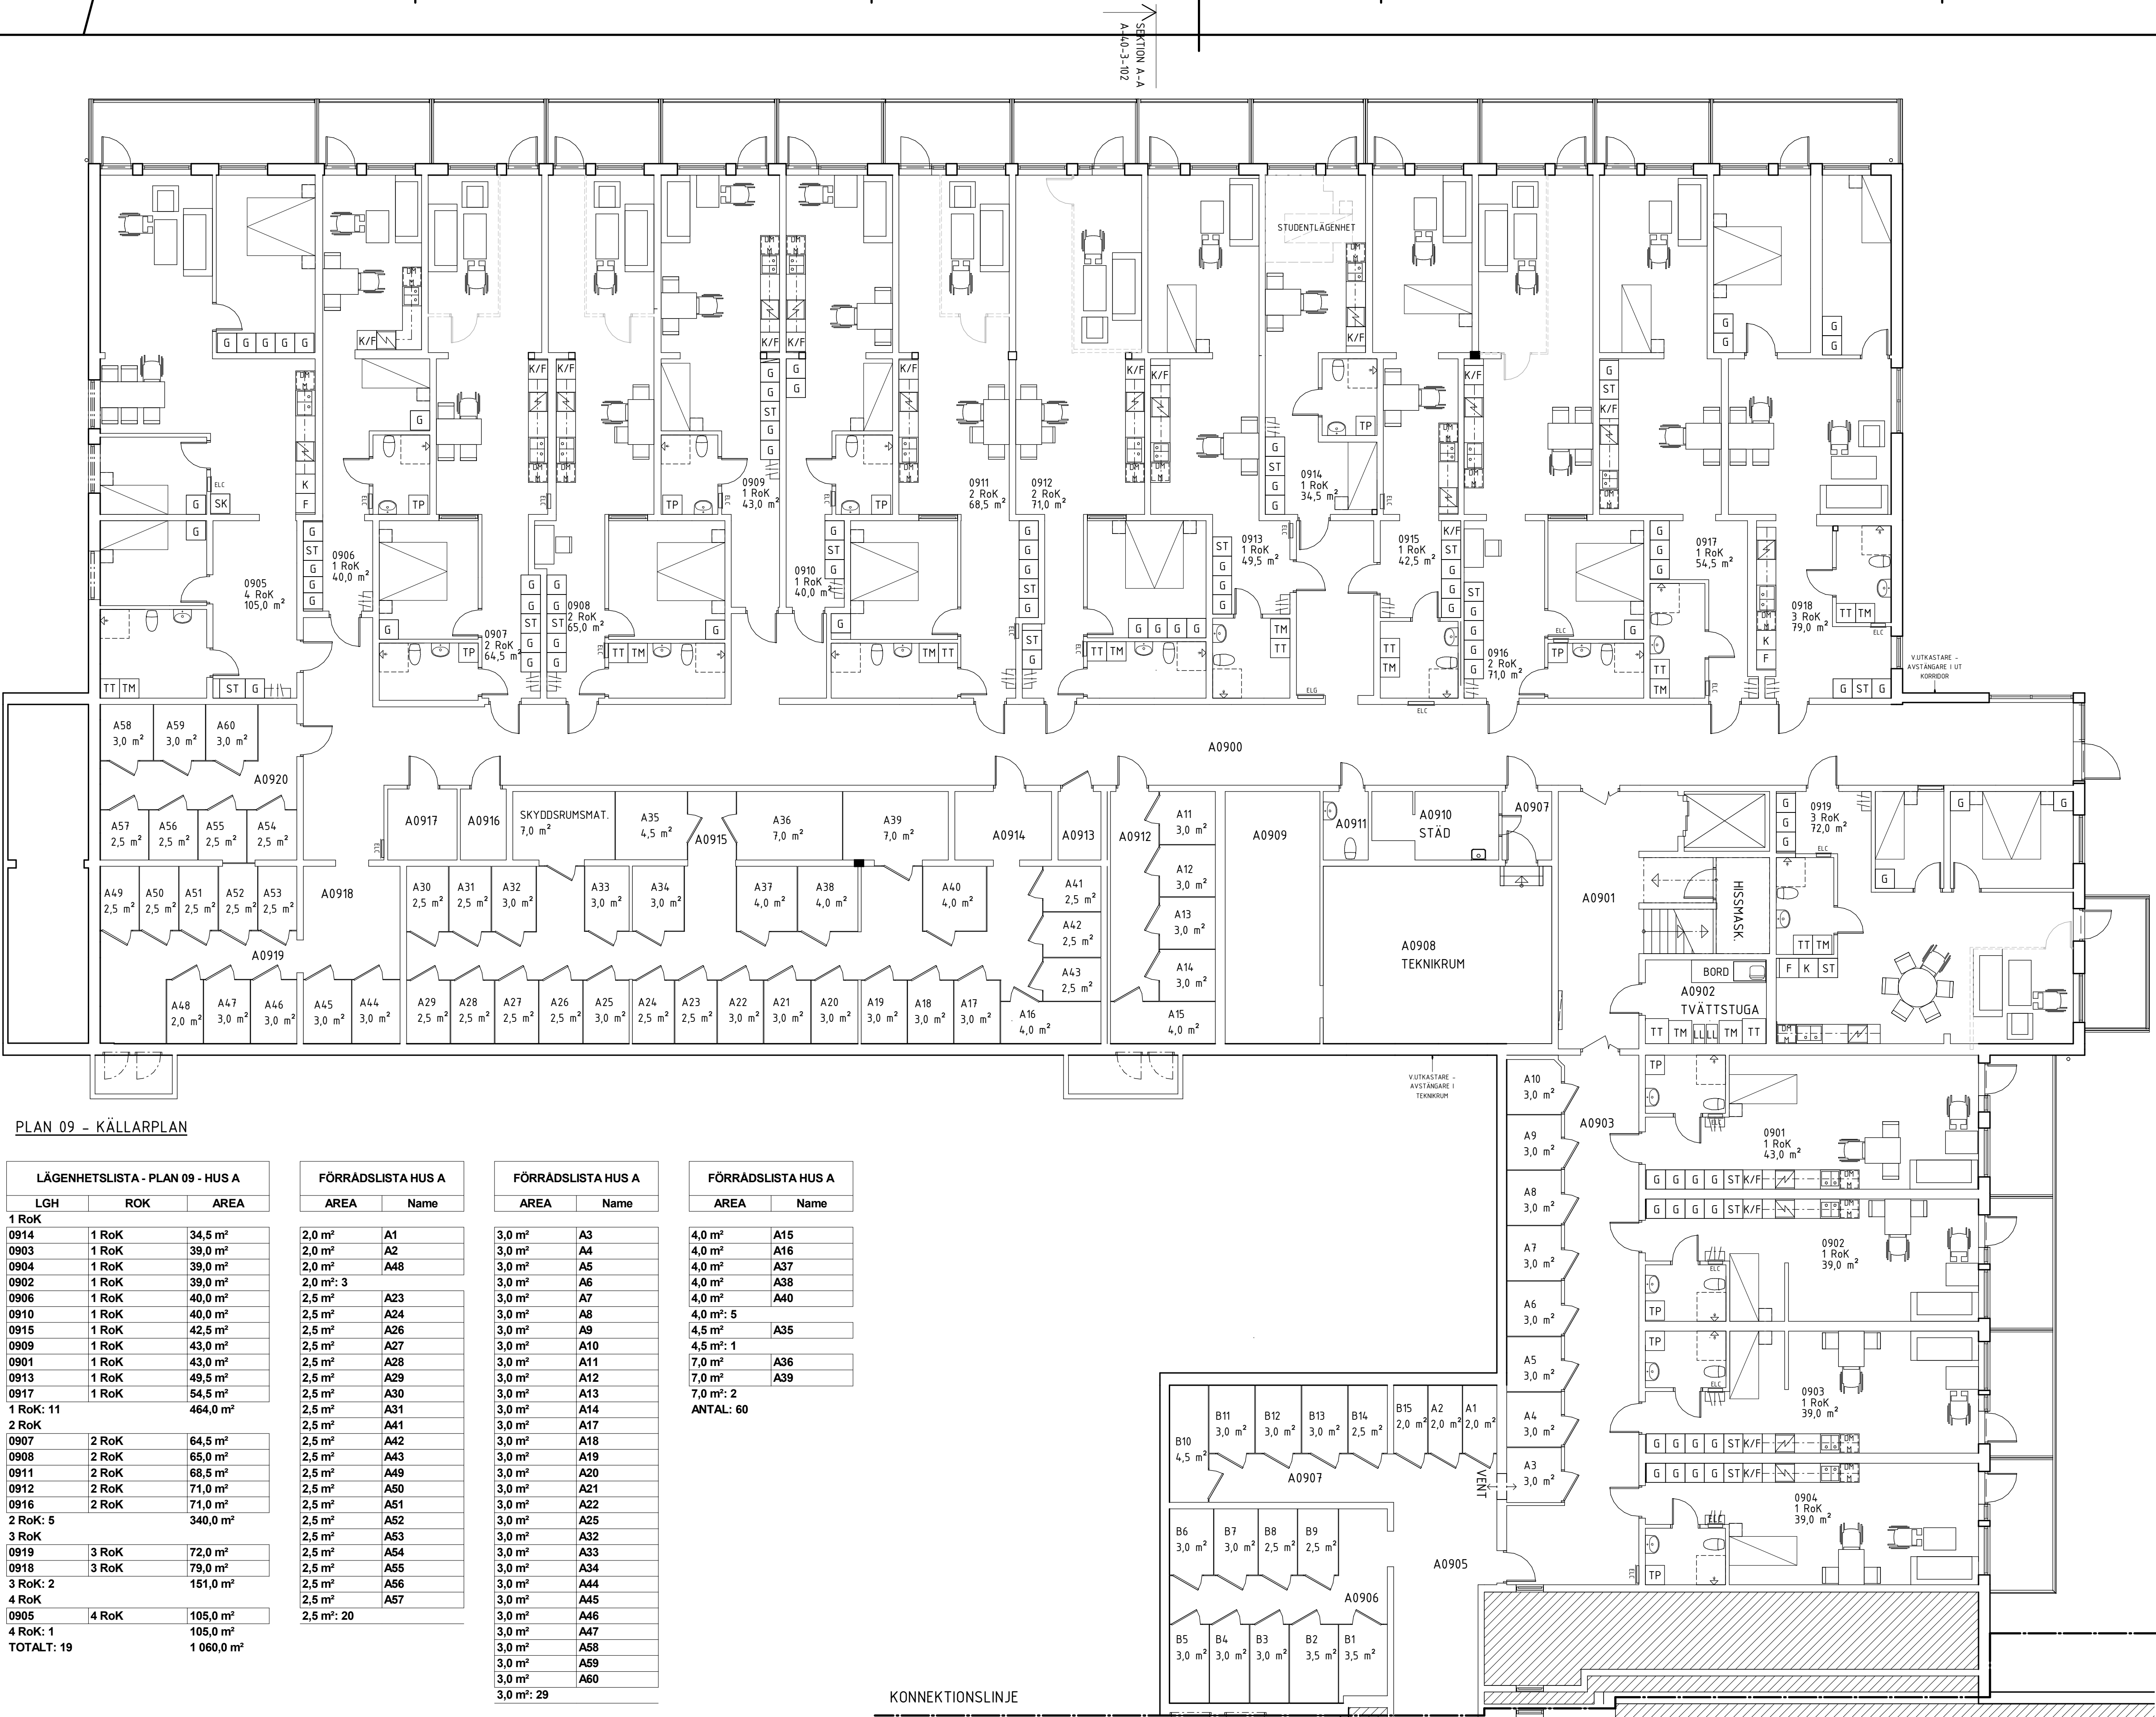

PLAN 09 – KÄLLARPLAN

LÄGENHETSLISTA - PLAN 09 - HUS A		
LGH	ROK	AREA
1 RoK		
0914	1 RoK	34,5 m²
0903	1 RoK	39,0 m²
0904	1 RoK	39,0 m²
0902	1 RoK	39,0 m²
0906	1 RoK	40,0 m²
0910	1 RoK	40,0 m²
0915	1 RoK	42,5 m²
0909	1 RoK	43,0 m²
0901	1 RoK	43,0 m²
0913	1 RoK	49,5 m²
0917	1 RoK	54,5 m²
1 RoK: 11		464,0 m²
2 RoK		
0907	2 RoK	64,5 m²
0908	2 RoK	65,0 m²
0911	2 RoK	68,5 m²
0912	2 RoK	71,0 m²
0916	2 RoK	71,0 m²
2 RoK: 5		340,0 m²
3 RoK		
0919	3 RoK	72,0 m²
0918	3 RoK	79,0 m²
3 RoK: 2		151,0 m²
4 RoK		
0905	4 RoK	105,0 m²
4 RoK: 1		105,0 m²
TOTALT: 19		1 060,0 m²

FÖRRÄDSLISTA HUS A	
AREA	Name
2,0 m²	A1
2,0 m²	A2
2,0 m²	A48
2,0 m²: 3	
2,5 m²	A23
2,5 m²	A24
2,5 m²	A26
2,5 m²	A27
2,5 m²	A28
2,5 m²	A29
2,5 m²	A30
2,5 m²	A31
2,5 m²	A41
2,5 m²	A42
2,5 m²	A43
2,5 m²	A49
2,5 m²	A50
2,5 m²	A51
2,5 m²	A52
2,5 m²	A53
2,5 m²	A54
2,5 m²	A55
2,5 m²	A56
2,5 m²	A57
2,5 m²: 20	

FÖRRÄDSLISTA HUS A	
AREA	Name
3,0 m²	A3
3,0 m²	A4
3,0 m²	A5
3,0 m²	A6
3,0 m²	A7
3,0 m²	A8
3,0 m²	A9
3,0 m²	A10
3,0 m²	A11
3,0 m²	A12
3,0 m²	A13
3,0 m²	A14
3,0 m²	A17
3,0 m²	A18
3,0 m²	A19
3,0 m²	A20
3,0 m²	A21
3,0 m²	A22
3,0 m²	A25
3,0 m²	A32
3,0 m²	A33
3,0 m²	A34
3,0 m²	A44
3,0 m²	A45
3,0 m²	A46
3,0 m²	A47
3,0 m²	A58
3,0 m²	A59
3,0 m²	A60
3,0 m²: 29	

FÖRRÄDSLISTA HUS A	
AREA	Name
4,0 m²	A15
4,0 m²	A16
4,0 m²	A37
4,0 m²	A38
4,0 m²	A40
4,0 m²: 5	
4,5 m²	A35
4,5 m²: 1	
7,0 m²	A36
7,0 m²	A39
7,0 m²: 2	
ANTAL: 60	

BET

ÄNDRINGEN AVSER

DATUM

SIGN

RELATIONSHANDLING

VÄLAGÅRDEN

TALLEN 14

TOMELLILA KOMMUN

HUS A

HUS B

PLAN 09

hassel

UPPDRAG NR 207901

DATUM: 2025-10-14

OMBYGGNATION TILL BOSTÄDER

HUS A - PLAN 09

SKALA: A1 1:100 A3 1:200

NUMMER: A-40-1-091

BET: